



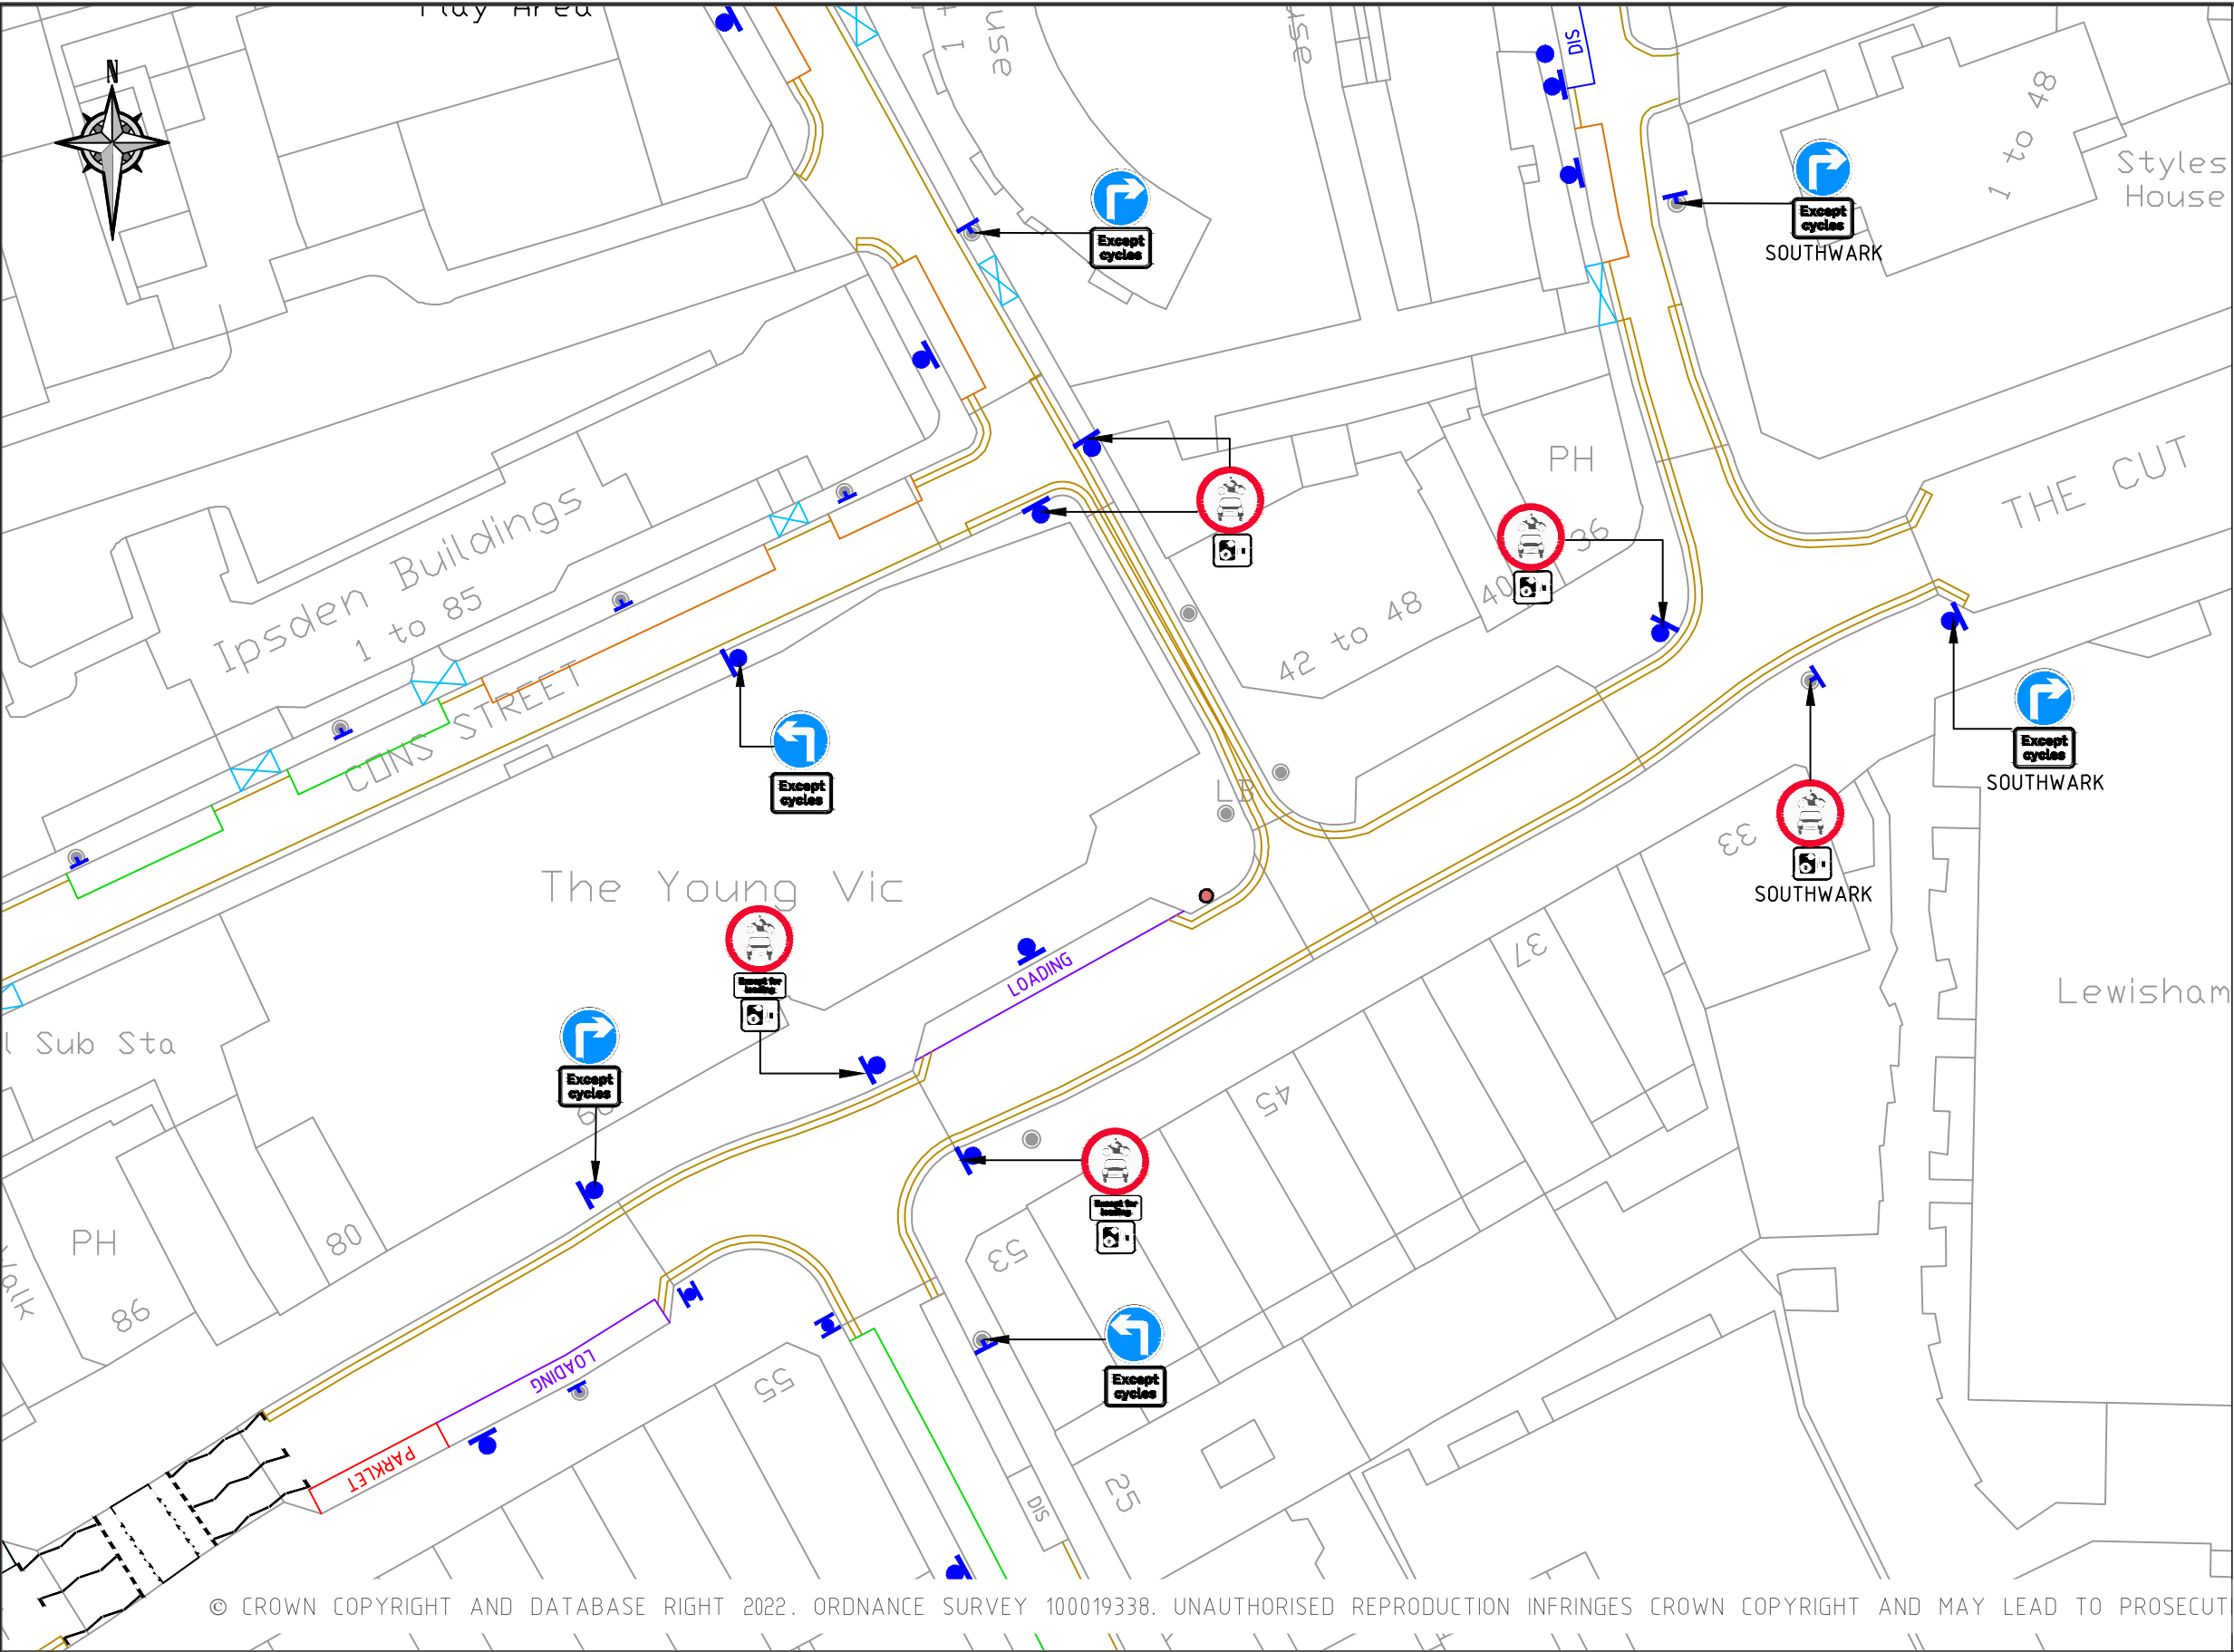

Sign Reference	619
Height	600mm
Width	600mm
Area	0.18 m ²
Material	Class RA2 (12899-1:2007)
Mount Height	2300

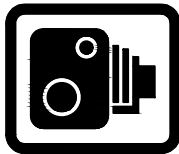

Scheme Ref.	LTN	x-height	100.0
Sign Ref.	878	SIGN FACE	
Letter colour	BLACK	Width	500mm
Background	WHITE	Height	400mm
Border	BLACK	Area	0.20m ²
Material	Class R3B Microprismatic		

Except for loading

Scheme Ref.	LTN	x-height	37.5
Sign Ref.	Ex Load	SIGN FACE	
Letter colour	BLACK	Width	455 mm
Background	WHITE	Height	215 mm
Border	BLACK	Area	0.10 m ²
Material	Class R2		

Except cycles

Scheme Ref.	LTN	x-height	37.5
Sign Ref.	512	SIGN FACE	
Letter colour	BLACK	Width	325mm
Background	WHITE	Height	215mm
Border	BLACK	Area	0.07m ²
Material	Class R3B Microprismatic		



Sign Reference	609R
Height	600 mm
Width	600 mm
Area	0.28 m ²
Material	Class R3B-UK
Mount Height	2300

NOTES:

REV	DESCRIPTION	DRAWN	SIG	DATE	CHKD	SIG	DATE	APP	SIG	DATE

Lambeth
PARKING, STREET MANAGEMENT
AND COMMERCIAL,
3RD FLOOR, CIVIC CENTRE
6 BRIXTON HILL
LONDON, SW2 1EG
020 7926 9000

DRAWN	BC	PROJECT	LTN - Sign Maintenance
CHKD	GL	DRAWING TITLE	The Cut
APP	LM	CLASSIFICATION	As Built
DATE	27.06.22	PAPER	A3
		SCALE	1:500
		DRAWING NO	DES-CPZ-LTN-WATER-034
		REVISION	-